


LOC	DIST	REVISIONS					
		P	LTR	DESCRIPTION	DATE	DWN	APVD
EH		H		REV PER ECN 0B10-0035-95	10MAY95	MKB	RS
		J		REV PER ECN 0B10-0075-95	10JUL95	MKB	RS
		K		REV PER ECN 0B10-0102-95	09AUG95	MKB	RS
		L		REV PER ECN 0B10-0122-95	06SEP95	MKB	RS
		M		REV PER ECN 0B10-0130-95	13SEP95	LMH	RS
		N		REV PER ECN 0B10-0086-96	19MAR96	LMH	RS
		P		REV PER ECN 0B10-0143-98	07JUL98	LMH	RS
		P1		REVISED PER ECO-09-022178	21SEP09	KK	AEG

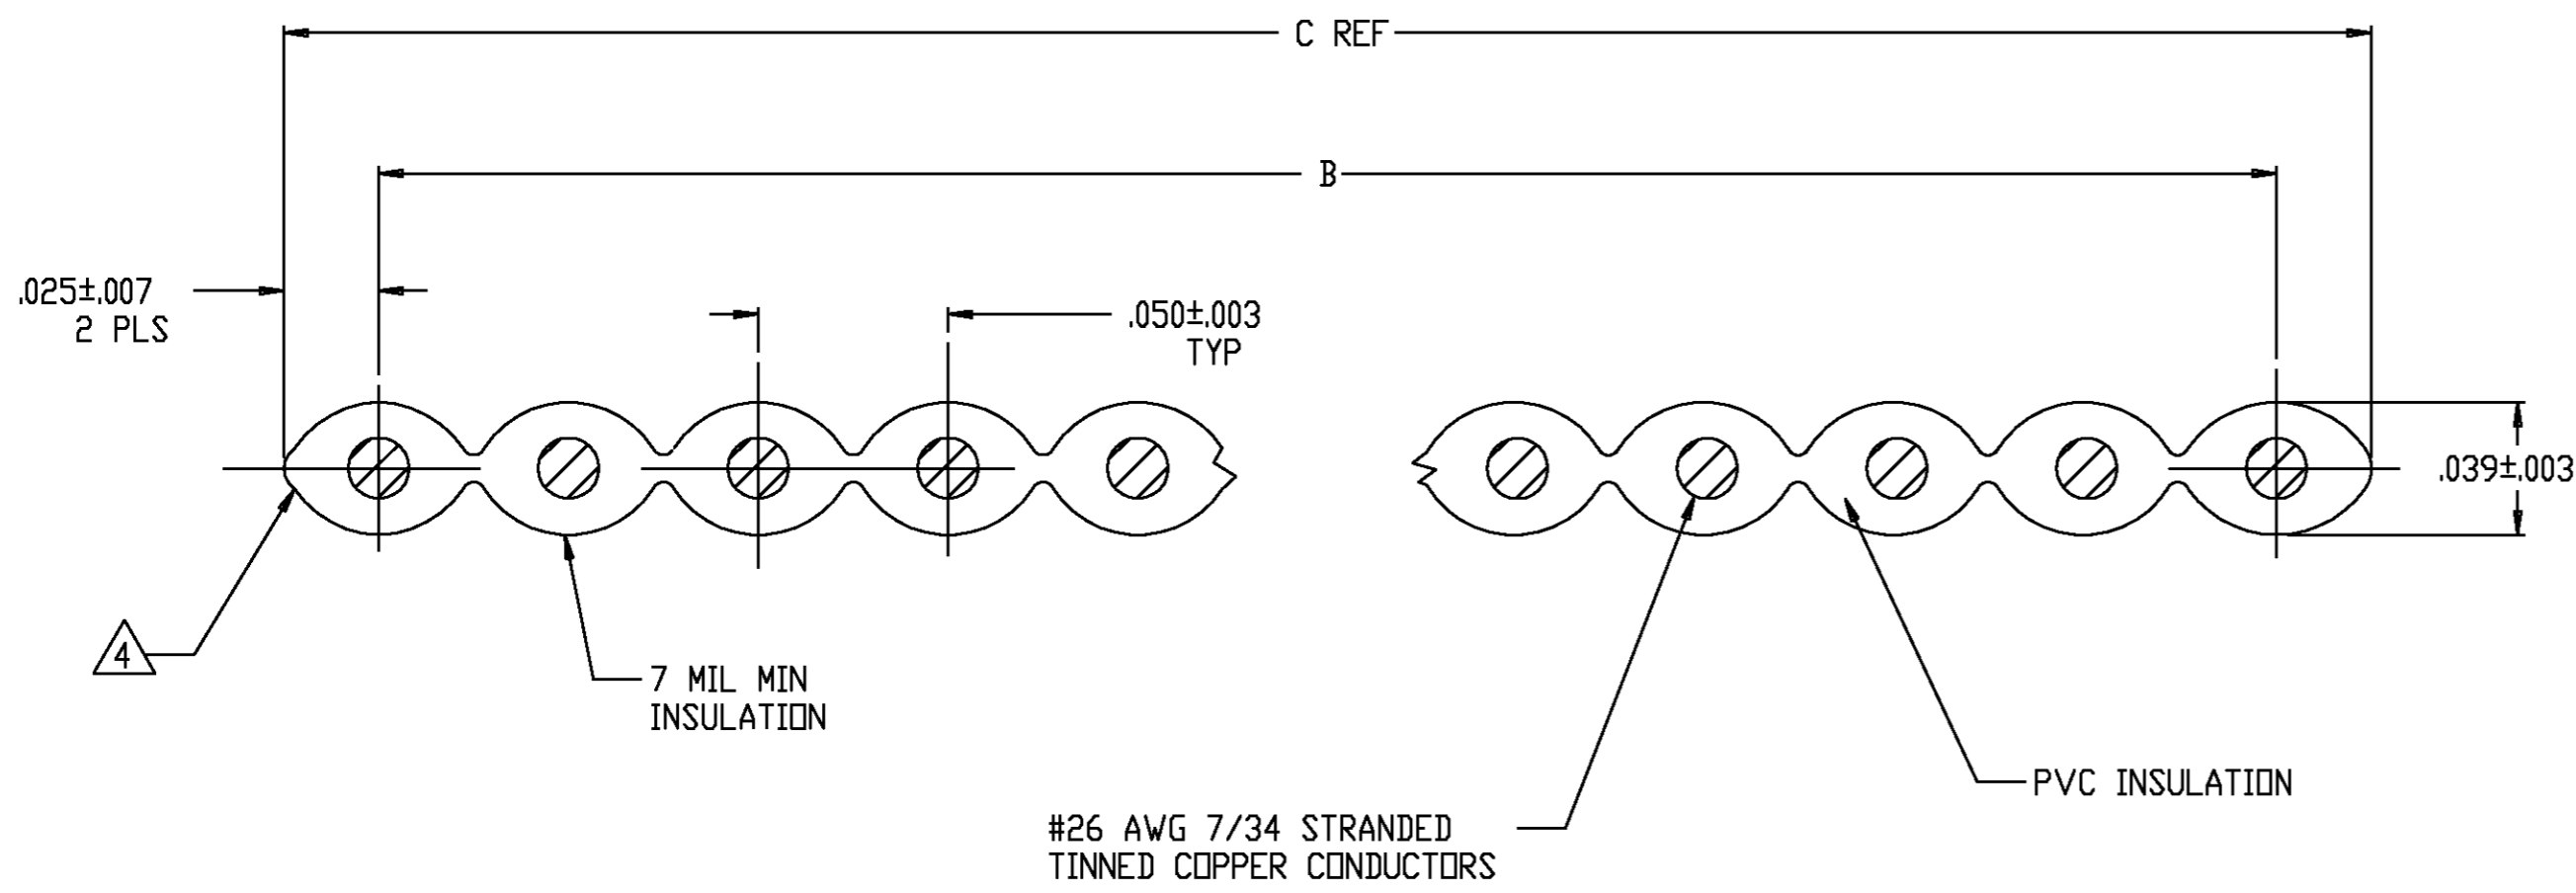

FLAT CABLE CROSS-SECTION

- CABLE CERTIFIED TO:
    - UL CABLE STYLE: 2651
    - CSA: CSA AWM IA 105°C 300V FT1
  - CABLE PHYSICAL SPECIFICATIONS:
    - 2.1 TEMPERATURE RATING: 105°C
    - 2.2 FLAMMABILITY:
      - UL: VW1
    - 2.3 INSULATION: GRAY FLAME RETARDANT FLEXIBLE PVC
    - 2.4 CONDUCTORS: 26 AWG 7/34 STRANDED TINNED COPPER
  - TYPICAL ELECTRICAL VALUES:
    - 3.1 VOLTAGE RATING: 300 V
    - 3.2 INSULATION RESISTANCE: 10,000 MEGOHMS/10 FT
    - 3.3 IMPEDANCE: 89 OHMS NOMINAL (GND-SIG-GND)
    - 3.4 CAPACITANCE: 16.2 pf/FT
    - 3.5 PROPAGATION DELAY: 1.44 ns/FT
- 4 RED EDGE MARK ON CONDUCTOR #1.
- REEL QUANTITY: 500 FT REEL MAY CONTAIN SEPARATE LENGTHS  
20 FT MIN PER LENGTH, TWO LENGTHS MAX PER REEL
  - CABLE SURFACE PRINTED PER UL AND CSA REQUIREMENTS.
- 7 OBSOLETE PARTS: OBSOLETE CIS STREAMLINING PER D.RENAUD/D.SINISI

7	OBsolete	DIM C	DIM B	NO OF COND	PART NUMBER
		.900	.850±.010	18	<del>3-57034-0</del>
		1.500	1.450±.010	30	2-57034-9
	7	.600	.550±.010	12	<del>2-57034-0</del>
		.400	.350±.010	8	<del>2-57034-7</del>
		2.200	2.150±.015	44	2-57034-6
		3.200	3.150±.015	64	2-57034-5
		.200	.150±.010	4	1-57034-9
		3.000	2.950±.015	60	1-57034-6
		2.500	2.450±.015	50	1-57034-5
		2.000	1.950±.015	40	1-57034-4
		1.850	1.800±.015	37	1-57034-3
	7	1.800	1.750±.015	36	<del>1-57034-2</del>
		1.700	1.650±.010	34	1-57034-1
		1.300	1.250±.010	26	1-57034-0
		1.250	1.200±.010	25	57034-9
		1.200	1.150±.010	24	57034-8
		1.000	.950±.010	20	57034-7
		.800	.750±.010	16	57034-6
		.750	.700±.010	15	57034-5
		.700	.650±.010	14	57034-4
		.500	.450±.010	10	57034-3
		.450	.400±.010	9	57034-2
		.300	.250±.010	6	57034-1
		DIM C	DIM B	NO OF COND	PART NUMBER

THIS DRAWING IS A CONTROLLED DOCUMENT.		DWN J.KOPPENHEFFER 03JUN92	AMP Incorporated Harrisburg, PA 17105-3608	
DIMENSIONS: INCHES	TOLERANCES UNLESS OTHERWISE SPECIFIED:	CHK W.HARRIS 05JUN92	AMP	
	0 PLC ±	APVD W.HARRIS 05JUN92	CABLE, PLANAR RIBBON, 26 AWG, 7/34 STRANDED	
	1 PLC ±.1	PRODUCT SPEC	SIZE A2	CAGE CODE 00779
	2 PLC ±.02	APPLICATION SPEC	DRAWING NO C=57034	RESTRICTED TO -
	3 PLC ±.005		SCALE NTS	SHEET 1 OF 1
	4 PLC ±.0005		CUSTOMER DRAWING	REV P1
	ANGLES ±			
MATERIAL	FINISH	WEIGHT		

## X-ON Electronics

Largest Supplier of Electrical and Electronic Components

*Click to view similar products for [Flat Cables](#) category:*

*Click to view products by [TE Connectivity](#) manufacturer:*

Other Similar products are found below :

[8132/08100](#) [FST-23A-15](#) [1301210030](#) [C336514-500](#) [902220736002000](#) [902220736006000](#) [28100-0614](#) [281000616](#) [281000625](#) [9L28014-008-H300](#) [28100-0571](#) [28100-0602](#) [281000624](#) [28100-0650](#) [28100-0664](#) [336512-300](#) [336518](#) [336537-CUT-LENGTH](#) [3447/10-100](#) [3625/08-30M](#) [362514100MSF](#) [40WDY00005](#) [5111993623](#) [336506-300](#) [336508-300](#) [C374910](#) [34WDY00006](#) [3749/10-100](#) [375630](#) [3-971111-6](#) [1-1437356-3](#) [57034-6](#) [812504](#) [8132/11100](#) [5-1437214-8](#) [1301210060](#) [1301210058](#) [1301190003](#) [1301210032](#) [5111196336](#) [607.5689.087](#) [607.5689.091](#) [3801/04](#) [1301210020](#) [3754/12](#) [902220736003000](#) [3625/22100MSF](#) [902220736005000](#) [902220736004000](#) [C3811/10-100](#)