


DRAWING MADE IN AMERICAN PROJECTION

LOC 6 SHEET 14

© 1970 BY AMP INCORPORATED. ALL RIGHTS RESERVED. AMP PRODUCTS COVERED BY PATENTS AND/OR PATENTS PENDING.

REVISIONS			
LTR	DESCRIPTION	DATE	APPROVED
D	<del>REV PER G-571</del>	2/1/88	<i>[Signature]</i>
E	REV PER G-571	2/24/90	OKS/PSG
C	331366 OBSOLETE G-2340	DAP 4/10/87	<i>[Signature]</i>

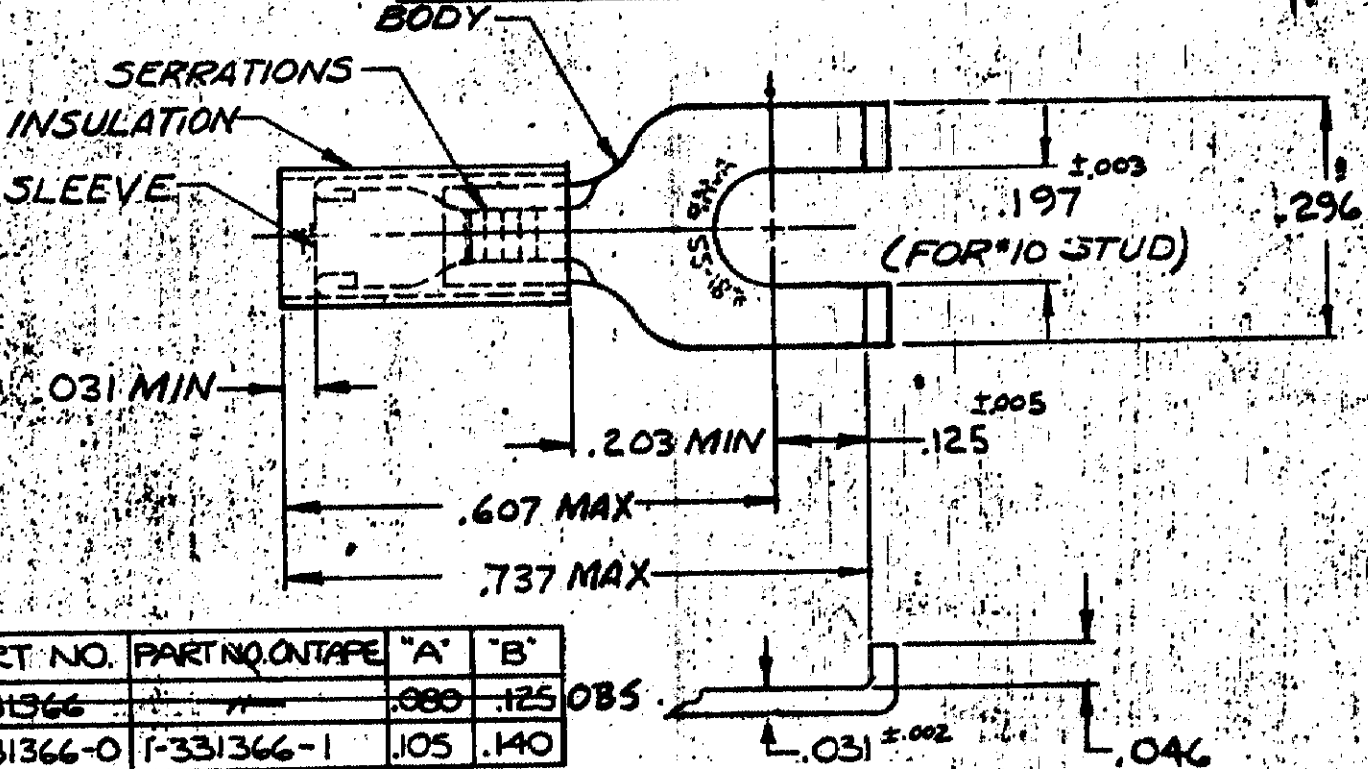

PART NO.	PART NO. ON TAPE	"A"	"B"
331366		.080	.125 OBS
1-331366-0	1-331366-1	.105	.140

FOR "A" TO "B" WIRE INS. DIA.  
MARKING 22-18 FOR MILITARY  
COMMERCIAL RANGE 22-16

1-331366-0 ON TAPE	1-331366-1	SLEEVE: COPPER (QQ-C-576)
WIRE	1-331366-0	BODY: COPPER (QQ-C-576)
Terminal	<del>331366</del> OBSOLETE	TIN PL (MIL-T-10727)
QTY DESCRIPTION PART NO		INSULATION: NYLON
		COLOR: RED
		MATERIAL & FINISH
UNLESS OTHERWISE SPECIFIED DIMENSIONS ARE IN INCHES. TOLERANCES ON: DECIMALS ±.008 ANGLES ±5°		 AMP INCORPORATED HARRISBURG, PENNSYLVANIA
CONTRACT NO. _____		
DR. <i>[Signature]</i> 8-14-70		NAME WIRE TERMINAL
CHK. <i>[Signature]</i> 8-17-70		
APPD. <i>[Signature]</i> 8-17-70		P.I.D.G. - FLANGED SPADE WIRE SIZE: 22-16
REL. <i>[Signature]</i> 8-17-70		
DSGN APPD		SIZE A
OTHER APPD		CODE IDENT NO. 00779
SEE TABLE		NUMBER 331366
		SCALE NTS
		SHEET 1 OF 1

## X-ON Electronics

Largest Supplier of Electrical and Electronic Components

*Click to view similar products for [Terminals](#) category:*

*Click to view products by [TE Connectivity](#) manufacturer:*

Other Similar products are found below :

[HT-13-10](#) [71M-250-32-NB](#) [01-2065-1-0216](#) [00581P0075](#) [M10-10RX](#) [M10BCK](#) [60205-1](#) [604200-1](#) [60598-1-CUT-TAPE](#) [60617-1-C](#) [60873-1](#) [M14-516R/SK](#) [M14-6RSX](#) [M18-10FLX](#) [M18-8FBX](#) [M18-8R/LX](#) [M18BCK](#) [61314-6-C](#) [61-S](#) [61-SN-A](#) [62-NBM-A](#) [63-S](#) [640179-1](#) [640917-2-CUT-TAPE](#) [6501550002](#) [66107-2-C](#) [696683-1](#) [696834-1](#) [696861-1](#) [696931-1](#) [696999-1](#) [M8-516RK](#) [M86700006](#) [MA250DMFMX-A](#) [701-2007](#) [701-2307](#) [701-7761-03](#) [70F-110-32-PB](#) [718-N-A](#) [71M-187-20-NBL](#) [71M-250-32-NBL](#) [72F-187-20-NBL](#) [72M-250-32-NBL](#) [7310](#) [73F-250-32](#) [73F-250-32-NBL](#) [73F-250-32-NL](#) [F14-10C](#) [F-1M](#) [751-250](#)