


328489

DRAWING MADE IN AMERICAN PROJECTION

LOC 6 PRINT 14

© AMP INCORPORATED. ALL RIGHTS RESERVED. AMP PRODUCTS COVERED BY PATENTS AND/OR PATENTS PENDING.

REVISIONS			
LTR	DESCRIPTION	DATE	APPROVED
B	REDRAWN & ADDED TAPE NO.	4-9-69	RHW
C	REVISED P-6075	2-5-70	FCY
D	ADDED STAMPING F-572	1-11-72	Jma
E	INACTIVE PER ECN P6742	2-11-72	Jma
F	INACTIVATED 2-328489-1 P-6800	3-5-72	Jma
G	REACTIVATED 328489 & 2-1 P-940	3-19-82	DJM
H	OBS 328489 G2610	10-28-87	PMF

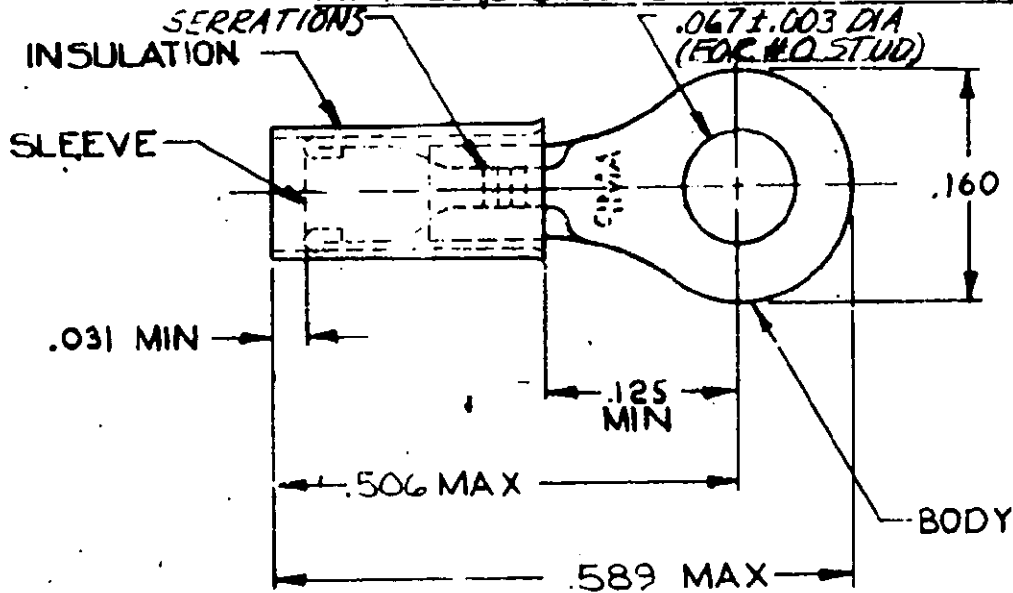

FOR .040 TO .100 WIRE INSULATION DIA.  
TONGUE MATERIAL THK. = .023<sup>±.002</sup>

(F)

1	<del>328489</del> ON TAPE	2-328489-1	BODY & SLEEVE: COPPER (QQ-C-576) TIN PL (MIL-T-10727)
1	WIRE TERMINAL	<del>328489</del> OBSOLETE	INSULATION: NATURAL NYLON (MIL-M-20693) TYPE I
QTY	DESCRIPTION	PART NO.	MATERIAL & FINISH
UNLESS OTHERWISE SPECIFIED DIMENSIONS ARE IN INCHES TOLERANCES ON: DECIMALS ± .000 ANGLES ± .000		CONTRACT NO.	AMP INCORPORATED HARRISBURG, PENNSYLVANIA
MATERIAL  SEE TABLE		DR. <i>Steve Hunt</i> 4-8-69 CHK. <i>R. J. [unclear]</i> 7-3-69 APPD. <i>[unclear]</i> 4-15-69 REL. <i>[unclear]</i> 4/15/69	NAME WIRE TERMINAL P.I.D.G RING TONGUE WIRE SIZE: 24-20
DSGN APPD		SIZE A	CODE IDENT NO. 00779
OTHER APPD		NUMBER 328489	PIN H
		SCALE NTS	SHEET CUSTOMER DRAWING

## X-ON Electronics

Largest Supplier of Electrical and Electronic Components

*Click to view similar products for [Terminals](#) category:*

*Click to view products by [TE Connectivity](#) manufacturer:*

Other Similar products are found below :

[HT-13-10](#) [71M-250-32-NB](#) [01-2065-1-0216](#) [00581P0075](#) [M10-10RX](#) [M10BCK](#) [60205-1](#) [604200-1](#) [60598-1-CUT-TAPE](#) [60617-1-C](#) [60873-1](#) [M14-516R/SK](#) [M14-6RSX](#) [M18-10FLX](#) [M18-8FBX](#) [M18-8R/LX](#) [M18BCK](#) [61314-6-C](#) [61-S](#) [61-SN-A](#) [62-NBM-A](#) [63-S](#) [640179-1](#) [640917-2-CUT-TAPE](#) [6501550002](#) [66107-2-C](#) [66107-4-C](#) [696683-1](#) [696834-1](#) [696861-1](#) [696931-1](#) [696999-1](#) [M8-516RK](#) [M86700006](#) [MA250DMFMX-A](#) [701-2007](#) [701-2307](#) [701-7761-03](#) [70F-110-32-PB](#) [718-N-A](#) [71M-187-20-NBL](#) [71M-250-32-NBL](#) [72F-187-20-NBL](#) [72M-250-32-NBL](#) [7310](#) [73F-250-32](#) [73F-250-32-NBL](#) [73F-250-32-NL](#) [F14-10C](#) [F-1M](#)