


DWG NO. 608696

UNIT OF MEASURE	A	B	C	D	E	G	L	MAX. BUNDLE DIA.	MIN. TENSILE STRENGTH
INCHES	1.081	.520	.307	.323	.080	.256	16.24	4.0	120 lbs.
MM	27.46	13.21	7.80	8.20	2.03	6.50	413.	101.5	54.43 kg.

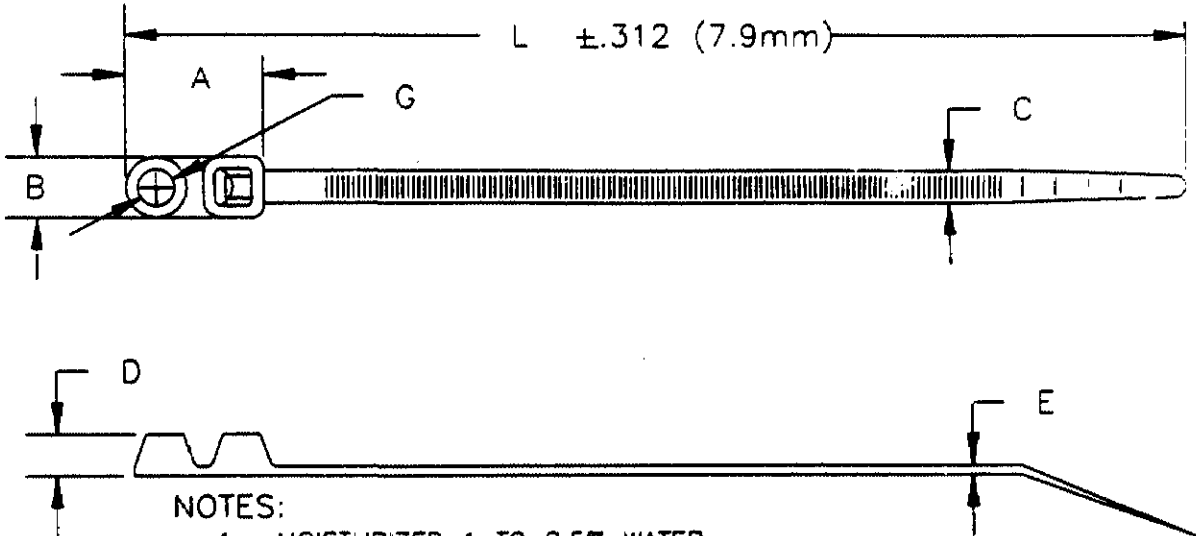

NOTES:

1. MOISTURIZED 1 TO 2.5% WATER.
2. PACKAGED IN HEAT SEALED 3 MIL POLYBAG WITH LABEL PER DWG 404707.

⚠️ OBSOLETE PARTS: OBSOLETE CIS STREAMLINING PER D.RENAUD/D.SINISI

ENGINEERING

JUL 13 1990

ISSUED BY *Alcu*

CUSTOMER DRAWING UNPUBLISHED

<del>OBSOLETE</del>	<del>3-608696-9</del>	NATURAL-500 PCS. SMTY4HL
⚠️ OBSOLETE	4-608696-9	NATURAL-50 PCS. SMTY4HD
<del>OBSOLETE</del>	<del>3-608696-0</del>	BLACK-500 PCS. SMTY4HLB
	4-608696-0	BLACK-50 PCS. SMTY4HDB

LOC	DIST	DWG SIZE	PART No.	DESCRIPTION	ITEM NO
D	1				
REVISION OF EACH ASSY NO. (WHEN BLANK, USE DWG REVISION)					
QTY. REQ'D. PER ASSY.			PARTS LIST		
			MATERIAL NYLON 6/6	HEAT TREAT	FINISH
			DIMENSIONS ARE IN INCHES	DRAWN BY: AD-TEK/VL	DATE: 7/3/90
			TOLERANCES UNLESS OTHER USE SPECIFIED: 2 PL DEC ± 3 PL DEC ± .039 4 PL DEC ±	CHECK BY: Bsm 7/90	APPROVED BY: J. Hamed 7/5/90
			ANGLES ± SURF TEXTURE: J	<b>AMP</b>   AMP INCORPORATED Harrisburg, Pa.	
			REMOVE BURRS, BREAK SHARP EDGES, .015 R. MAX.	NAME: 1/4in. SCREW MOUNT CABLE TIE 16 1/4 INCH	
P	F	LTR	REVISION RECORD	APP	DATE
			01 ECO-09-026444	AEG	DEC09
			0 ECN 062890	MW	7/90
			SCALE: A	DRAWING No.:	608696
				SHEET:	1 OF 1
				REV.:	01

THIS INFORMATION IS CONFIDENTIAL AND IS DISCLOSED TO YOU ON CONDITION THAT NO FURTHER DISCLOSURE IS MADE BY YOU TO OTHER THAN AMP PERSONNEL WITHOUT WRITTEN AUTHORIZATION FROM AMP INCORPORATED, HARRISBURG, PA.