


1 OBSOLETE PARTS: OBSOLETE CIS STREAMLINING PER D.RENAUD/D.SINISI  
 2 OBSOLETE


DO NOT SCALE

DIMENSIONS IN MM.

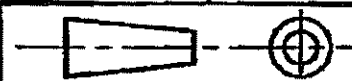

C.A.D. FILE CODE  
S. C154718.AD

PART NUMBER	MATERIAL	FINISH	REELING	LOOSE PIECE (REF. ONLY)
154718-1	BRASS	NONE	STANDARD	341002-1
154718-2	PHOS. BRONZE	NONE	STANDARD	341002-2
154718-3	BRASS	TIN	STANDARD	341002-3
154718-4	PHOS. BRONZE	TIN	STANDARD	<del>341002-4</del> 2
1 154718-5	PHOS. BRONZE	NONE	STANDARD	341002-5
154718-6	BRASS	PRE-TIN	STANDARD	341002-6
154718-7	PHOS. BRONZE	PRE-TIN	STANDARD	341002-7
154718-8	BRASS	SILVER	STANDARD	341002-8
154718-9	BRASS	SILVER	STANDARD	341002-9
<del>1-154718-0</del>	BRASS	PRE-TIN	STANDARD	---
1-154718-1	BRASS	NONE	REV. REEL VERSION-1	---
1-154718-2	PHOS. BRONZE	NONE	REV. REEL VERSION-2	---
<del>1-154718-3</del>	PHOS. BRONZE	PRE-TIN	STANDARD	---
2 1-154718-4	BRASS	TIN	REV. REEL VERSION-3	---
1-154718-5	PHOS. BRONZE	TIN	REV. REEL VERSION-4	---

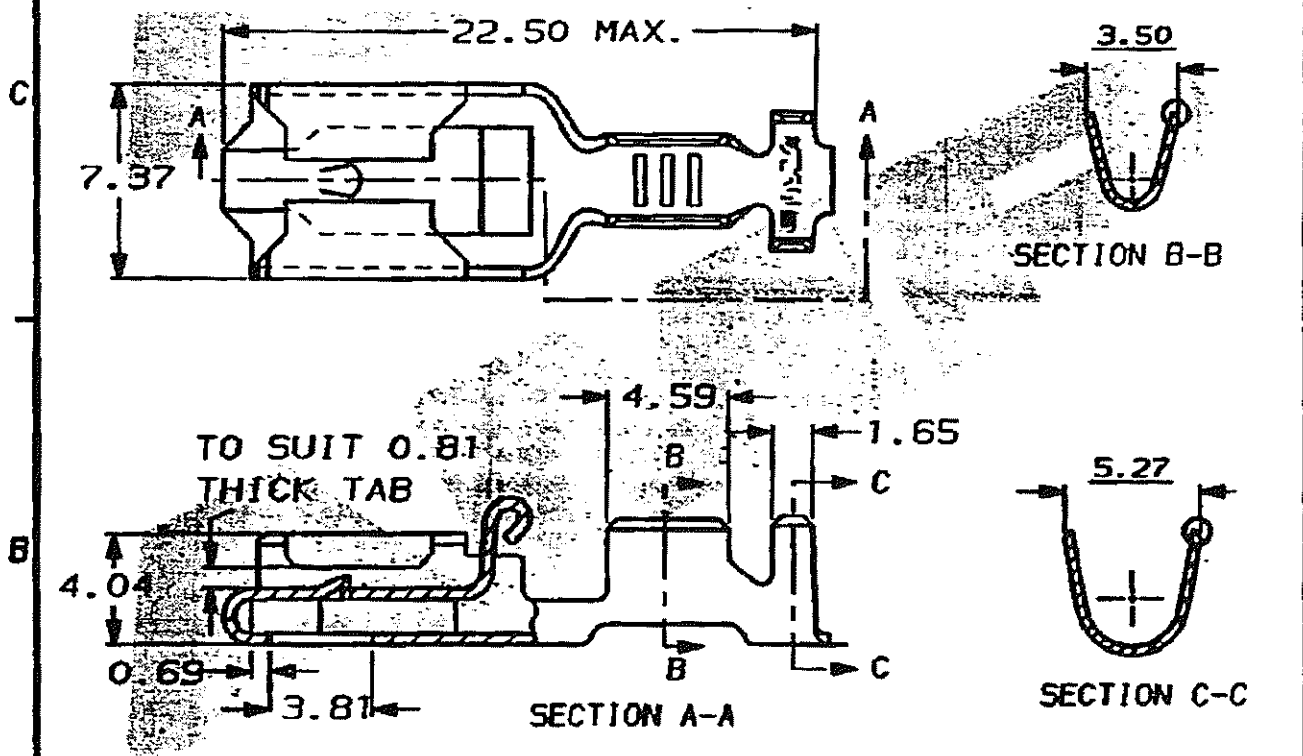

WIRE RANGE 0.7 TO 2.0mm<sup>2</sup>

INSULATION RANGE 2.4 TO 3.2mm DIA.

CUSTOMER DWG  
FOR REFERENCE ONLY

RELEASED FOR PUBLICATION  
ORIGINAL 1974

A

TOLERANCES  
UNLESS OTHERWISE  
STATED  
DEC ± 0.5  
ANGLES ± 1°

DR. D.A. BARRATT 27.11.91  
 CH. D. TERRY APP. D.A. BARRATT



NAME POSITIVE LOCK RECEPTACLE

AD2	REVISED PER ECO-11.005150	RK/HMR	28MAR11	SCALE	LOC	SIZE	DWG. No.	REV	SHEET
REV	ECN	APPROVED	DATE	4/1	E	A4	C154718	AD2	1/1

## X-ON Electronics

Largest Supplier of Electrical and Electronic Components

*Click to view similar products for [Automotive Connectors](#) category:*

*Click to view products by [TE Connectivity](#) manufacturer:*

Other Similar products are found below :

[003-018-000](#) [60403001](#) [60993906-B](#) [M902-2131](#) [M902-2161](#) [72.330.1035.1](#) [73.353.4028.0](#) [F119300-B](#) [F166900](#) [F258300-B](#) [F358300-B](#)  
[F407400](#) [F444110](#) [F487000](#) [F509500B-B](#) [827153-1](#) [8N1515-32-24P](#) [9-1326729-8](#) [925474-1](#) [928905-1](#) [964562-4](#) [968782-1](#) [GT17SA-8DS-](#)  
[HU](#) [98891-1012](#) [98947-1016](#) [12004147](#) [12004475-L](#) [12010290](#) [12010309-B](#) [12015454](#) [12020219-B](#) [12020308](#) [12041318-B](#) [12052225-L](#)  
[12052466](#) [12059125](#) [12064869](#) [12004327-B](#) [12010503-B](#) [12015308](#) [12015384](#) [12015909](#) [1-21030-1](#) [12041254](#) [12041318](#) [12047946-B](#)  
[12047957](#) [12047957-L](#) [12059473](#) [12066261](#)