



THIS DRAWING IS UNPUBLISHED. RELEASED FOR PUBLICATION  
 © COPYRIGHT - BY TYCO ELECTRONICS CORPORATION. ALL RIGHTS RESERVED.

LOC	DIST	REVISIONS			
P	LTR	DESCRIPTION	DATE	DWN	APVD
G	02	H1	REV PER ECR 07-017037	20JUL07	JR TM

AMP WIRE RANGE	AMP INSULATION RANGE
22-16 AWG 0.3-1.5 mm <sup>2</sup>	.140 MAX DIA 3.5 MAX DIA

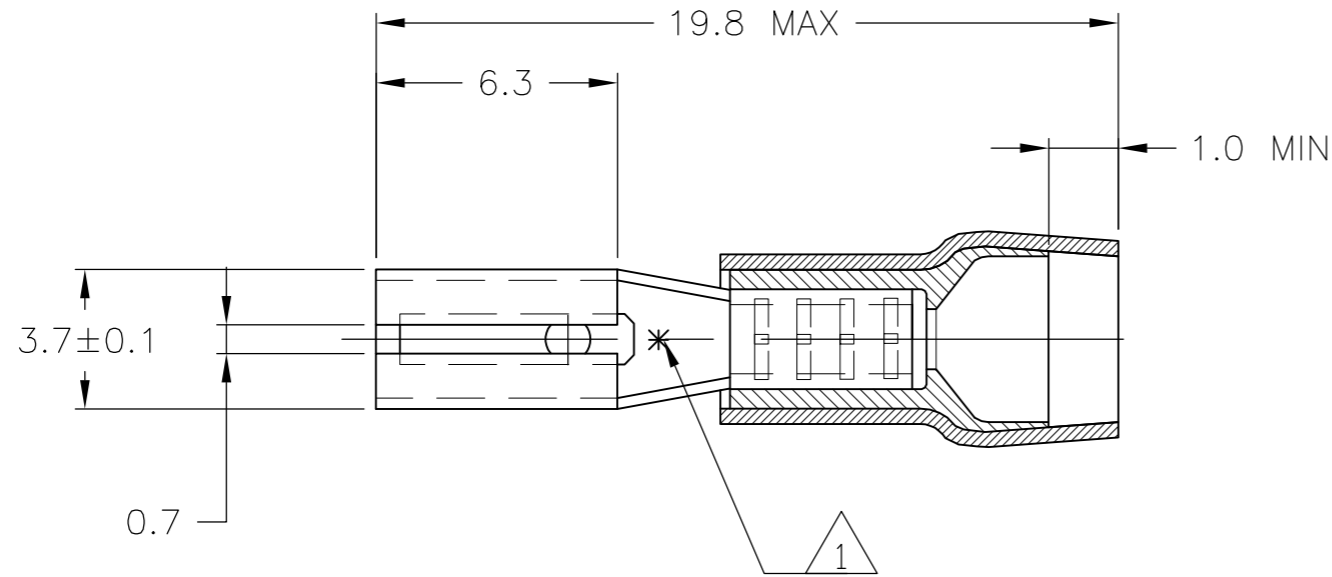

- △1 ASTERISK \* FOR PHOS BRONZE VERSION ONLY
- △2 OBSOLETE W/O REPLACEMENT

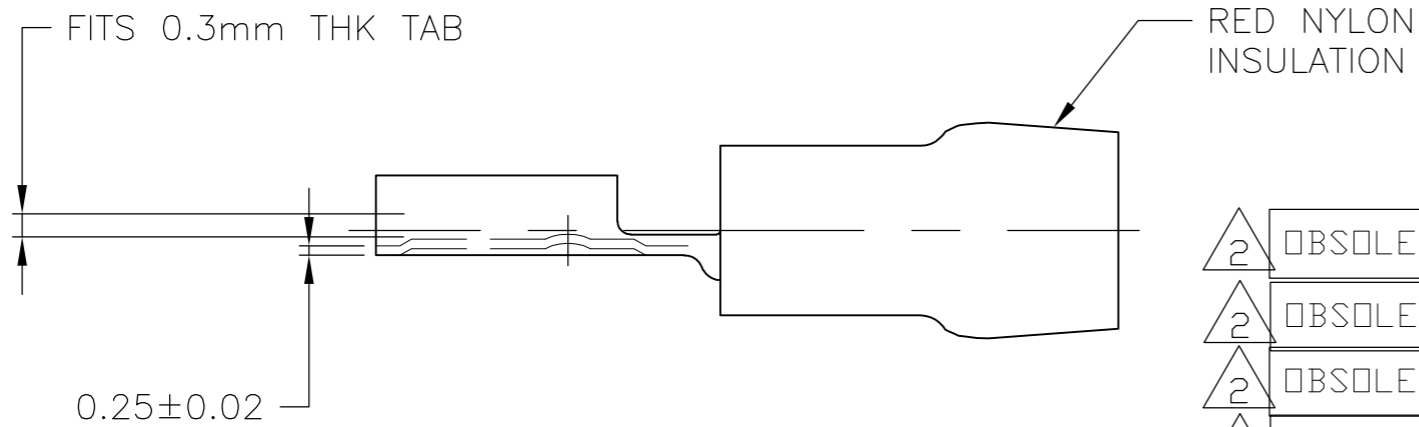

△2	OBSOLETE	<del>2-165563-6</del>	<del>GOLD</del>	<del>PHOS BRONZE</del>	<del>165563-6</del>
△2	OBSOLETE	<del>2-165563-5</del>	<del>GOLD</del>	<del>BRASS</del>	<del>165563-5</del>
△2	OBSOLETE	<del>2-165563-4</del>	<del>SILVER</del>	<del>PHOS BRONZE</del>	<del>165563-4</del>
△2	OBSOLETE	<del>2-165563-3</del>	<del>SILVER</del>	<del>BRASS</del>	<del>165563-3</del>
△2	OBSOLETE	<del>2-165563-2</del>	<del>TIN</del>	<del>PHOS BRONZE</del>	<del>165563-2</del>
		<del>2-165563-1</del>	<del>TIN</del>	<del>BRASS</del>	<del>165563-1</del>
		PN ON TAPE	FINISH	MATERIAL	PART NUMBER

THIS DRAWING IS A CONTROLLED DOCUMENT.		DWN jr_ruth 15APR05	Tyco Electronics Corporation Harrisburg, Pa 17105-3608		
DIMENSIONS: mm		CHK T MICHIELUTTI 15APR05	NAME RECEPTACLE, FASTON, PIDG, .110 SERIES		
TOLERANCES UNLESS OTHERWISE SPECIFIED: 0 PLC ± - 1 PLC ± 0.2 2 PLC ± - 3 PLC ± - 4 PLC ± - ANGLES ± 5'		APVD T MICHIELUTTI 15APR05	PRODUCT SPEC - APPLICATION SPEC -		
MATERIAL -	FINISH -	WEIGHT -	SIZE A3	CAGE CODE 00779	DRAWING NO C-165563
CUSTOMER DRAWING			SCALE 1:1	SHEET 1 OF 1	REV H1

## X-ON Electronics

Largest Supplier of Electrical and Electronic Components

*Click to view similar products for [Terminals](#) category:*

*Click to view products by [TE Connectivity](#) manufacturer:*

Other Similar products are found below :

[00-054007-01074-6](#) [00-054007-70206-1](#) [00-054007-70210-8](#) [00-054007-70217-7](#) [00-054007-70226-9](#) [00-054007-70228-3](#) [00-054007-70248-1](#) [00-054007-70256-6](#) [00-054007-70301-3](#) [00-054007-70316-7](#) [0-0320562-0](#) [00-054007-49560-4](#) [00-054007-70209-2](#) [00-054007-70225-2](#) [00-054007-70227-6](#) [00-054007-70231-3](#) [00-054007-70241-2](#) [00-054007-70242-9](#) [00-054007-70244-3](#) [00-054007-70246-7](#) [00-054007-70263-4](#) [00-054007-70288-7](#) [00-054007-70290-0](#) [00-054007-70300-6](#) [00-054007-70304-4](#) [01-2065-1-0216](#) [01-2900-1-04412](#) [00581P0075](#) [600TS-10](#) [60205-1](#) [604200-1](#) [605601-1](#) [60598-1-CUT-TAPE](#) [61314-6-C](#) [61810-3](#) [61-S](#) [61-SN](#) [626-0194](#) [62-NBM-A](#) [62-SN](#) [62-SP](#) [63-S](#) [640179-1](#) [M55155/059I03](#) [M55155/079C01](#) [M55155/099H02](#) [M55155/109H01](#) [M55155/109H02](#) [M55155/12XH05](#) [M55155/16XH02](#)