

DRAWING MADE IN THIRD ANGLE PROJECTION

© COPYRIGHT 1977 BY AMP INCORPORATED, HARRISBURG, PA.
 ALL INTERNATIONAL RIGHTS RESERVED. AMP INCORPORATED PRODUCTS
 COVERED BY U. S. AND FOREIGN PATENTS AND/OR PATENTS PENDING.

3 207438-2 1. AS SHOWN.

207438-3

207438-5


1. SAME AS -2 EXCEPT:
 2. LOOSE PIECE

~~DISCREPANCY~~ EXCEPT:
 DISCREPANCY

REVISIONS			
P. NO.	ZONE	DESCRIPTION	DATE
G		OBSOLETED - 57EEN R-2613	12-87
H		REV PER EC 0020 - 289-93	5-3-93

1 Loc BD DIST 39

POINT OF PLATING THICKNESS MEASUREMENT (SIDE OPPOSITE SEAM)

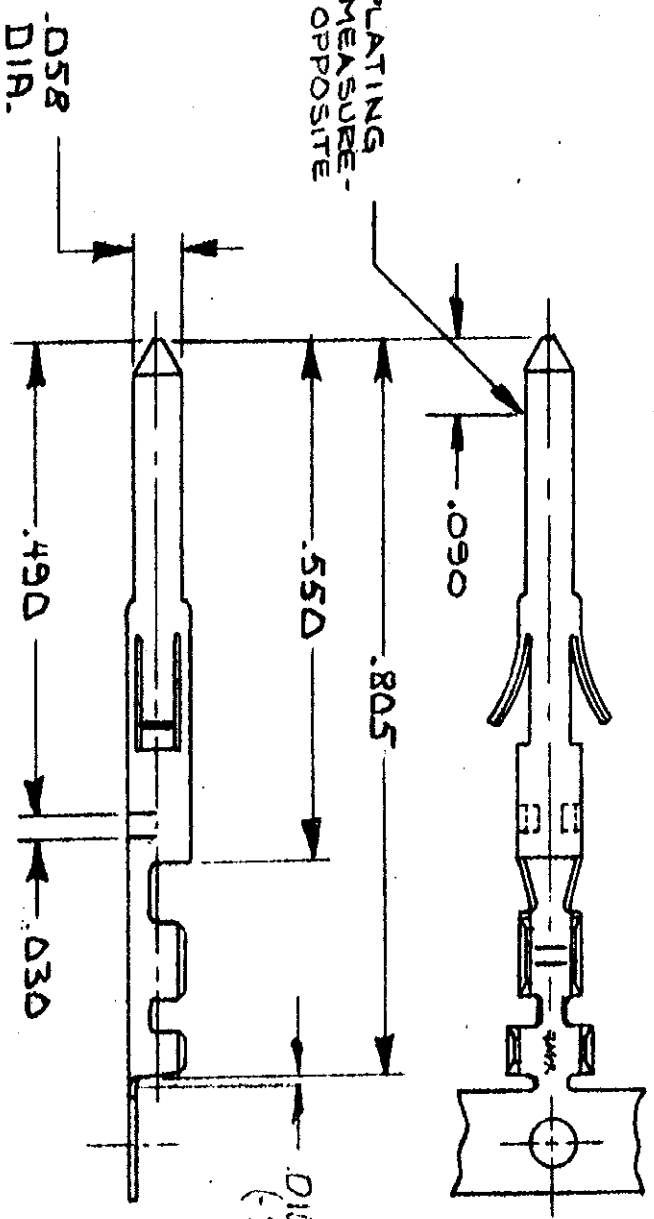

3 -8 1. SAME AS -2 EXCEPT;
 2. GOLD FLASH / III. PLATED.
 -9 1. SAME AS -8 EXCEPT;
 2. LOOSE PIECE.
 DID MAX CUTOFF (-3-5, -7 & -9 ONLY)

~~OBsolete~~ EXCEPT;
 SELECT GOLD/III. PLATED.
~~OBsolete~~ EXCEPT;
 2. LOOSE PIECE.

1. WIRE RANGE = 22-28.
2. INSULATION RANGE = .036 - .054 D/A.
3. REVERSE REELED FOR MINI-APPLICATOR.

UNLESS OTHERWISE SPECIFIED DIMENSIONS ARE IN INCHES. TOLERANCES ON: DECIMALS ± .005 ANGLES ± .1°

MATERIAL BRASS

FINISH TIN PLATE

CONTRACT NO. DR 3-2-77

APPROV. DATE 3/3/77

DESIGN APPRO. DATE 2/1/77

NAME CONTRACT, PIN

SIZE CODE IDENT. NO. DRAWING NO. B 00729 207438

SCALE 1/251 SHEET 1051



CUSTOMER DRAWING

AMP 1470-15 (7-73)

X-ON Electronics

Largest Supplier of Electrical and Electronic Components

Click to view similar products for [Headers & Wire Housings](#) category:

Click to view products by [TE Connectivity](#) manufacturer:

Other Similar products are found below :

[892-18-020-10-001101](#) [58102-G61-06LF](#) [582553-1](#) [0009485154](#) [009176003701906](#) [0050291907](#) [LY20-4P-DT1-P1E-BR](#) [02.125.8002.8](#)
[609-3404](#) [61062-3](#) [61082-181009](#) [622-3653LF](#) [63453-116](#) [636-1030](#) [636-1427](#) [636-3427](#) [636-4007](#) [641938-9](#) [641991-4](#) [644827-2](#) [65817-010LF](#) [65817-015LF](#) [65863-015LF](#) [66207-023LF](#) [67095-007LF](#) [67601157](#) [68645-018](#) [68648-049](#) [70.362.1628.0](#) [70-4210](#) [70-4226B](#) [70-4853B](#) [707-5020](#) [707-5028](#) [71.350.2428.0](#) [71918-208LF](#) [71961-016LF](#) [733-134](#) [733-162](#) [754199-000](#) [760-3052](#) [787-8014-00](#) [79531-3000](#)
[FCN-360C032-B](#) [FCN-367T-T012/H](#) [FCN-723D010/2](#) [80.063.4001.1](#) [800-90-001-10-001000](#) [800-90-010-10-002000](#) [801-43-002-10-013000](#)