

THIS DRAWING IS UNPUBLISHED. RELEASED FOR PUBLICATION
 © COPYRIGHT 2014 Tyco Electronics Japan G.K. ALL RIGHTS RESERVED.

LOC	DIST	REVISIONS					
J	ZDI	P	LTR	DESCRIPTION	DATE	DWN	APVD
			C	REVISED	30MAR2015	K.R	N.Y

注記





① 材料：ハウジング：ガラス入り熱可塑性ポリエステル樹脂（94V-0），色：黒

~~② ハウジング全面にテフロン塗装のこと~~


NOTES

① MATERIAL:HOUSING:GLASS FILED THERMO PLASTIC ,POLYESTER(94V-0),COLOR:BLACK

~~② TO COAT ALL SURFACE OF HOUSING WITH TEFLON~~

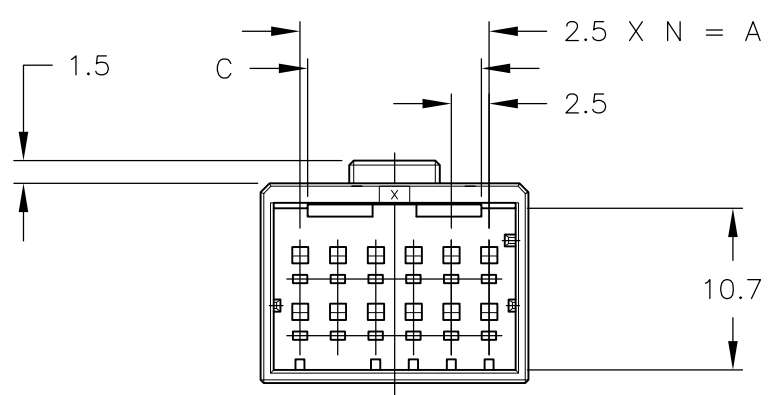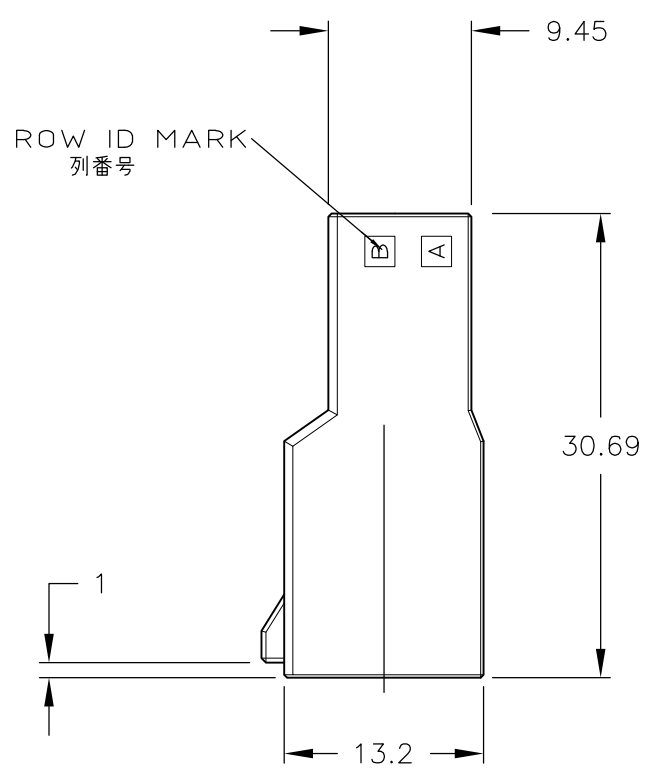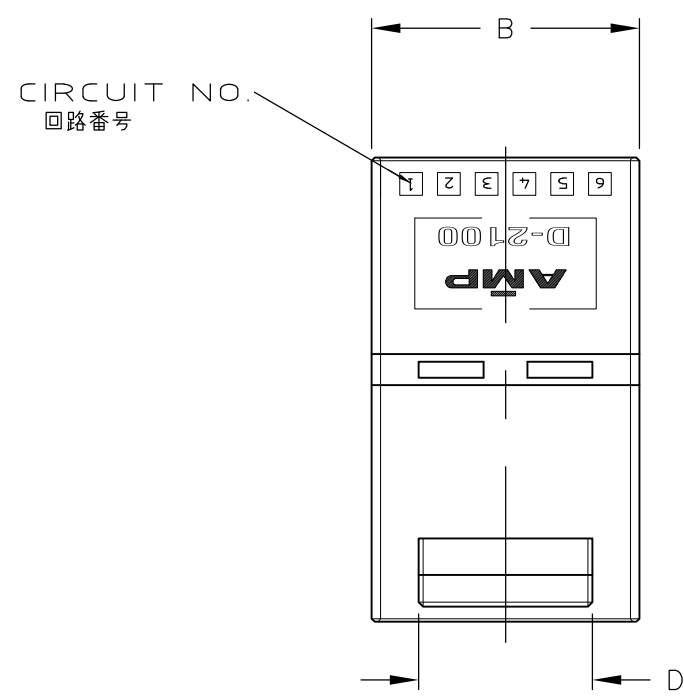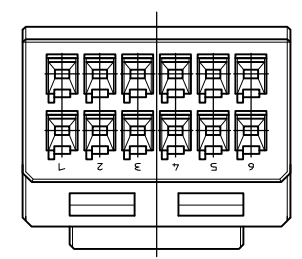

TOLERANCES UNLESS OTHERWISE SPECIFIED:
 一般公差
 10 ≧ : ±0.3
 30 ≧ : ±0.35
 100 ≧ : ±0.4
 ANGLE : ±3°

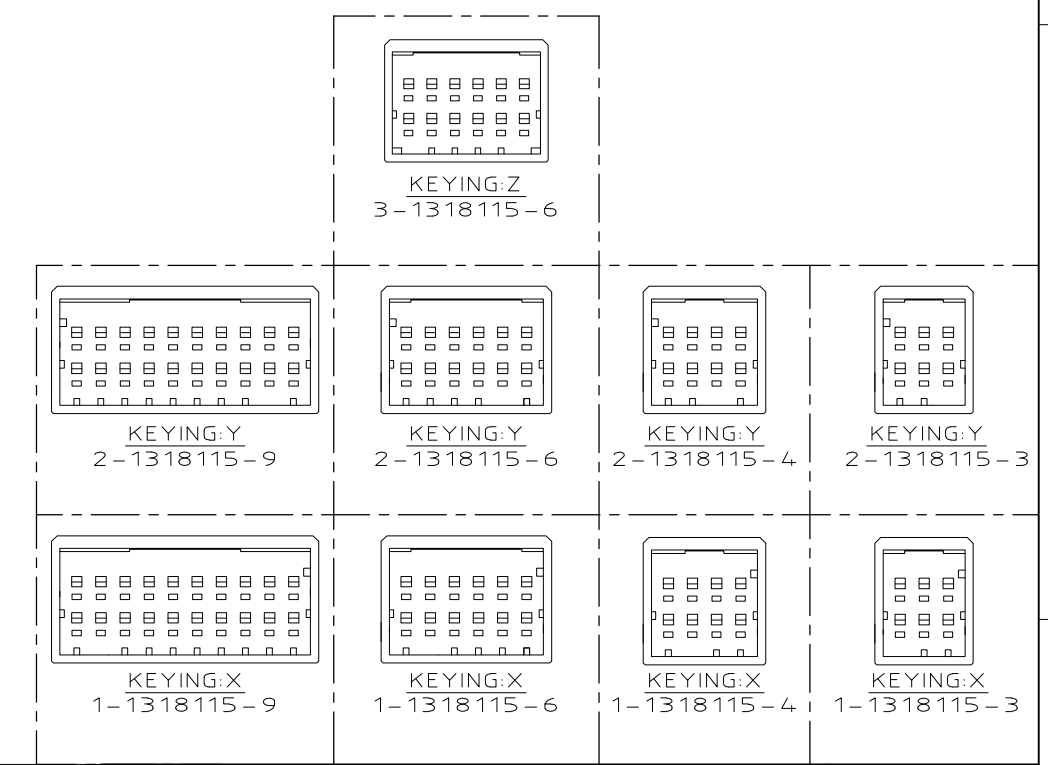

OBSOLETE	△	22.5	27.7	11.5	11.5	9	20	5-1318115-9	
	-	22.5	27.7	11.5	11.5	9	20	2-1318115-9	
	-	22.5	27.7	11.5	11.5	9	20	1-1318115-9	
OBSOLETE	△	12.5	17.7	11.5	11.5	5	12	5-1318115-6	
	-	12.5	17.7	11.5	11.5	5	12	3-1318115-6	
	-	12.5	17.7	11.5	11.5	5	12	2-1318115-6	
OBSOLETE	△	7.5	12.7	4	4	3	8	5-1318115-4	
	-	7.5	12.7	4	4	3	8	2-1318115-4	
	-	7.5	12.7	4	4	3	8	1-1318115-4	
OBSOLETE	△	5	10.2	4	4	2	6	5-1318115-3	
	-	5	10.2	4	4	2	6	2-1318115-3	
	-	5	10.2	4	4	2	6	1-1318115-3	
		FINISH	A	B	C	D	N	POS	P/N

THIS DRAWING IS A CONTROLLED DOCUMENT.

DIMENSIONS: mm	TOLERANCES UNLESS OTHERWISE SPECIFIED:	DWN K.IKEDA 7/DEC/'98	STE TE Connectivity
	0 PLC ±-	CHK N.MATSUBARA 7/DEC/'98	
	1 PLC ±-	APVD I.HASEGAWA 7/DEC/'98	
	2 PLC ±-	NAME	
MATERIAL	3 PLC ±-	PRODUCT SPEC	2列タブハウジングフリーハンギングタイプ
	4 PLC ±-	APPLICATION SPEC	DOUBLE ROW TAB (FREE HANGING)
	ANGLES ±-	WEIGHT	DYNAMIC D2100D
	FINISH	CUSTOMER DRAWING	SIZE A3 CAGE CODE 00779 DRAWING NO C-1318115 RESTRICTED TO
		SCALE 2:1 SHEET 1 OF 1 REV C	

X-ON Electronics

Largest Supplier of Electrical and Electronic Components

Click to view similar products for [Headers & Wire Housings](#) category:

Click to view products by [TE Connectivity](#) manufacturer:

Other Similar products are found below :

[892-18-020-10-001101](#) [58102-G61-06LF](#) [582553-1](#) [0009485154](#) [009176003701906](#) [0050291907](#) [LY20-4P-DT1-P1E-BR](#) [02.125.8002.8](#)
[609-3404](#) [61062-3](#) [61082-181009](#) [622-3653LF](#) [63453-116](#) [636-1030](#) [636-1427](#) [636-3427](#) [636-4007](#) [641938-9](#) [641991-4](#) [644827-2](#) [65817-](#)
[010LF](#) [65817-015LF](#) [65863-015LF](#) [66207-023LF](#) [67095-007LF](#) [67601157](#) [68645-018](#) [68648-049](#) [70.362.1628.0](#) [70-4210](#) [70-4226B](#) [70-](#)
[4853B](#) [707-5020](#) [707-5028](#) [71.350.2428.0](#) [71918-208LF](#) [71961-016LF](#) [733-134](#) [733-162](#) [754199-000](#) [760-3052](#) [787-8014-00](#) [79531-3000](#)
[FCN-360C032-B](#) [FCN-367T-T012/H](#) [FCN-723D010/2](#) [80.063.4001.1](#) [800-90-001-10-001000](#) [800-90-010-10-002000](#) [801-43-002-10-013000](#)