


THIS DRAWING IS UNPUBLISHED. RELEASED FOR PUBLICATION  
 © COPYRIGHT

REVISIONS						
P	F	ZONE	LTR	DESCRIPTION	DATE	APPROVED
			J1	REVISED PER ECO-11-005294	13APR11	HMR

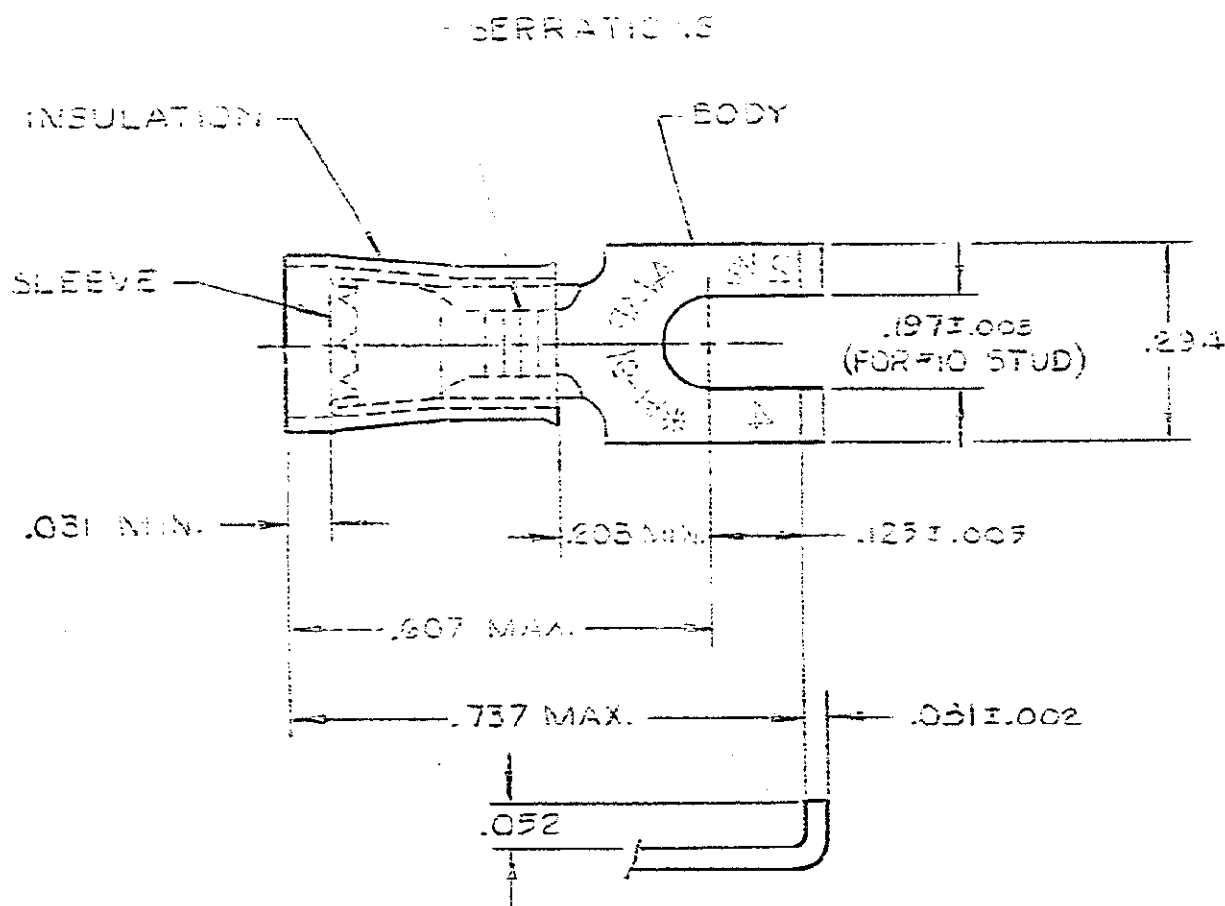

- 1. WIRE INSULATION DIA. - SEE TABLE
- 2. BODY FINISH: TIN PLATE (MIL-T-10727) .000100 MIN THK

QTY	WIRE INS DIA	QUANTITY	DESCRIPTION	PART NO
100	.115 - .170	100	LOOSE PC, BOX	8-320863-1
<del>100</del>	<del>.115 - .170</del>	<del>100</del>	<del>ON TAPE, SW. BOX</del>	<del>2-320863-6</del>
<del>100</del>	<del>.115 - .170</del>	<del>100</del>	<del>ON TAPE, LA. BOX</del>	<del>2-320863-5</del>
<del>100</del>	<del>.115 - .170</del>	<del>100</del>	<del>LOOSE PIECE</del>	<del>2-320863-3</del>
5000	.115 - .170	5000	ON TAPE, REEL	2-320863-2
1	.115 - .170	1	LOOSE PIECE	320863

UNLESS OTHERWISE SPECIFIED DIMENSIONS ARE IN INCHES. TOLERANCES ON: DECIMALS ± .008 ANGLES ±		CONTRACT NO DR UTA / SFB 9-30-89			
MATERIAL INSULATION: NYLON - BLUE BODY / SLEEVE: COPPER (33-C-576)		CHK <i>Phu...</i>			
FINISH BODY:		APPD <i>...</i>		SIZE <b>B</b>	FSCM NO <b>00779</b>
		DSGN APPD		DRAWING NO <b>320863</b>	
		OTHER APPD		SCALE NTS	
				SHEET 1 OF 1	

## X-ON Electronics

Largest Supplier of Electrical and Electronic Components

*Click to view similar products for [Terminals](#) category:*

*Click to view products by [TE Connectivity](#) manufacturer:*

Other Similar products are found below :

[00-054007-01074-6](#) [00-054007-70206-1](#) [00-054007-70210-8](#) [00-054007-70217-7](#) [00-054007-70226-9](#) [00-054007-70228-3](#) [00-054007-70248-1](#) [00-054007-70256-6](#) [00-054007-70301-3](#) [00-054007-70316-7](#) [0-0320562-0](#) [00-054007-49560-4](#) [00-054007-70209-2](#) [00-054007-70225-2](#) [00-054007-70227-6](#) [00-054007-70231-3](#) [00-054007-70241-2](#) [00-054007-70242-9](#) [00-054007-70244-3](#) [00-054007-70246-7](#) [00-054007-70263-4](#) [00-054007-70288-7](#) [00-054007-70290-0](#) [00-054007-70300-6](#) [00-054007-70304-4](#) [01-2065-1-0216](#) [01-2900-1-04412](#) [00581P0075](#) [600TS-10](#) [60205-1](#) [604200-1](#) [605601-1](#) [60598-1-CUT-TAPE](#) [61314-6-C](#) [61810-3](#) [61-S](#) [61-SN](#) [626-0194](#) [62-NBM-A](#) [62-SN](#) [62-SP](#) [63-S](#) [640179-1](#) [M55155/059I03](#) [M55155/079C01](#) [M55155/099H02](#) [M55155/109H01](#) [M55155/109H02](#) [M55155/12XH05](#) [M55155/16XH02](#)