
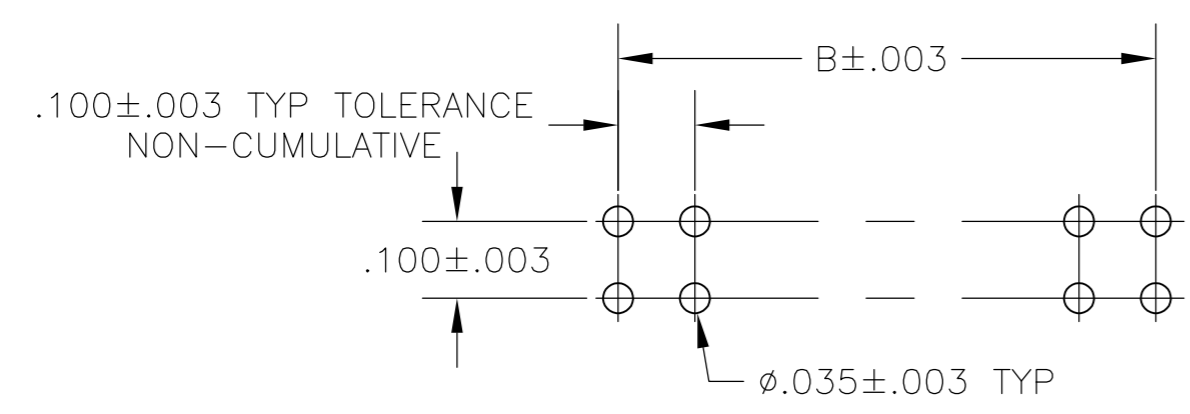
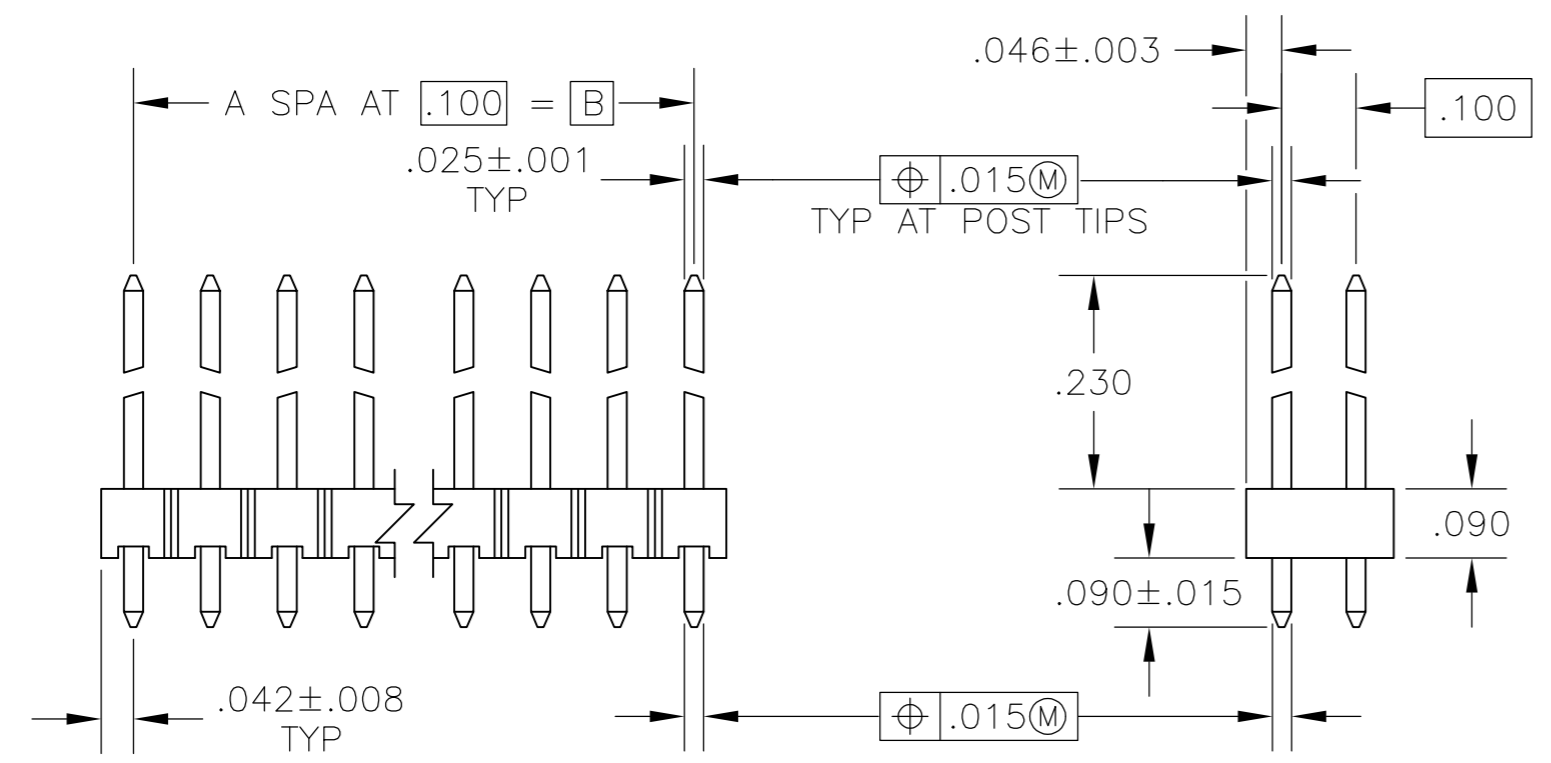


THIS DRAWING IS UNPUBLISHED. RELEASED FOR PUBLICATION  
 © COPYRIGHT - By - ALL RIGHTS RESERVED.

LOC		DIST		REVISIONS					
AD		00		P	LTR	DESCRIPTION	DATE	DWN	APVD
				F2		REVISED PER ECO-11-004820	11MAR11	RK	HMR

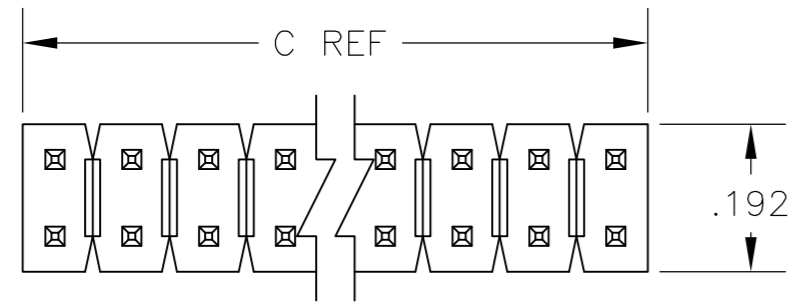

RECOMMENDED HOLE LAYOUT

- 1 ASSEMBLIES MAY BE BROKEN TO THE DESIRED NUMBER OF POSITIONS
- 2 TRUE POSITION TOLERANCE OF THE POST TIPS APPLIES WHEN THE HEADERS ARE HELD FLAT AGAINST THE PRINTED CIRCUIT BOARD
- 3 .000100-.000200 MATTE TIN-LEAD OVER .000050 NICKEL ENTIRE POST
- 4 OBSOLETE PARTS: OBSOLETE CIS STREAMLINING PER D.RENAUD/D.SINISI

<div style="border: 1px solid black; padding: 5px; display: inline-block;"> <p style="font-size: 2em; margin: 0;">4</p> </div> <div style="border: 1px solid black; padding: 5px; display: inline-block; writing-mode: vertical-rl; transform: rotate(180deg);"> <p style="margin: 0;">OBSOLETE</p> </div>	3.984	3.900	39	80	4-103777-0
	<del>3.884</del>	<del>3.800</del>	<del>38</del>	<del>78</del>	<del>3- -9</del>
	<del>3.784</del>	<del>3.700</del>	<del>37</del>	<del>76</del>	<del>3- -8</del>
	<del>3.684</del>	<del>3.600</del>	<del>36</del>	<del>74</del>	<del>3- -7</del>
	<del>3.584</del>	<del>3.500</del>	<del>35</del>	<del>72</del>	<del>3- -6</del>
	<del>3.484</del>	<del>3.400</del>	<del>34</del>	<del>70</del>	<del>3- -5</del>
	<del>3.284</del>	<del>3.300</del>	<del>33</del>	<del>68</del>	<del>3- -4</del>
	<del>3.184</del>	<del>3.100</del>	<del>31</del>	<del>64</del>	<del>3- -2</del>
	<del>3.084</del>	<del>3.000</del>	<del>30</del>	<del>62</del>	<del>3- -1</del>
	<del>2.984</del>	<del>2.900</del>	<del>29</del>	<del>60</del>	<del>3- -0</del>
	<del>2.884</del>	<del>2.800</del>	<del>28</del>	<del>58</del>	<del>2- -9</del>
	<del>2.784</del>	<del>2.700</del>	<del>27</del>	<del>56</del>	<del>2- -8</del>
<del>.484</del>	<del>.400</del>	<del>4</del>	<del>10</del>	<del>-5</del>	
<del>.384</del>	<del>.300</del>	<del>3</del>	<del>8</del>	<del>-4</del>	
<del>.284</del>	<del>.200</del>	<del>2</del>	<del>6</del>	<del>-3</del>	
<del>.184</del>	<del>.100</del>	<del>1</del>	<del>4</del>	<del>-2</del>	
<del>.084</del>	-	-	<del>2</del>	<del>103777-1</del>	
C	B	A	NO OF POS	ASSEMBLY PART NUMBER	

THIS DRAWING IS A CONTROLLED DOCUMENT.		DWN	L. RINGLEY	7-25-85		TE Connectivity				
DIMENSIONS: INCHES		CHK	R. ELICKER	7-25-85		ASSEMBLY, MOD II, HEADER, BREAKAWAY, DOUBLE ROW, .100X .100 C/L, WITH .025 SQUARE POSTS				
TOLERANCES UNLESS OTHERWISE SPECIFIED:		APVD	R. ELICKER	7-25-85						
0 PLC ± - 1 PLC ± - 2 PLC ± - 3 PLC ± .005 4 PLC ± - ANGLES ± - FINISH		PRODUCT SPEC	-			SIZE	A2	CAGE CODE	00779	DRAWING NO
MATERIAL: HOUSING, FLAME RETARDANT THERMOPLASTIC; COLOR-BLACK; POST: PHOSPHOR BRONZE		APPLICATION SPEC	-		WEIGHT	-	SCALE	4:1	SHEET	1 of 1
POSTS 3		CUSTOMER DRAWING	-		RESTRICTED TO	-				

## X-ON Electronics

Largest Supplier of Electrical and Electronic Components

*Click to view similar products for te connectivity manufacturer:*

Other Similar products are found below :

[570416-000](#) [CLTEQ-M81CE-SSRELAY-4-20V](#) [D38999/24FJ4AN](#) [358838-000](#) [4-1195131-0](#) [650069-000](#) [SMD100-2](#) [CB-1022B-78](#)  
[RM707012](#) [RP410012](#) [MMS42](#) [1-640426-8](#) [2EDL4CM](#) [DTS20W19-11PD-3028-LC](#) [RM202615](#) [NC6-P104-06](#) [MSPS103B](#) [DTS26F21-41AE](#) [DTS26F21-41PE-LC](#) [DTS26F21-11SE-3028-LC](#) [1932144-1](#) [293545-4](#) [LVR125S](#) [MS27466T25F4PB](#) [CKB-38-78010](#)  
[1206SFF150F/63-2](#) [D38999/20JB35HA](#) [D38999/24WJ20PA](#) [1754138-1](#) [TE1500A2R2J](#) [DTS24F25-29PC-3028-LC](#) [D38999/24WG11HA](#)  
[D38999/24WG11HN](#) [MS27467T21F11H](#) [DJT16E21-11HA](#) [1206SFH150F/24-2](#) [DTS24F19-11SC-3028-LC](#) [DTS24F21-41HN-LC](#)  
[DTS24F21-41AN](#) [DTS24F21-41PN-LC](#) [MS27467T21F35J](#) [MS27467T21F11J](#) [MS27467T21F16H-LC](#) [MS27467T21F35H](#)  
[MS27467T21F41H-LC](#) [DJT16E21-11PA-LC](#) [DJT16E21-11HA-LC](#) [DJT16E21-11AA](#) [MS27467T21B11JA](#) [DJT16E21-11JA](#)