
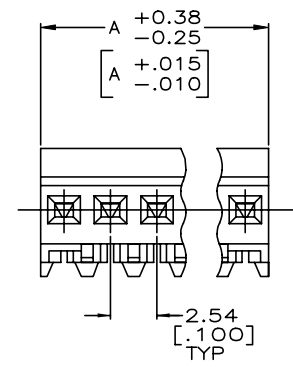
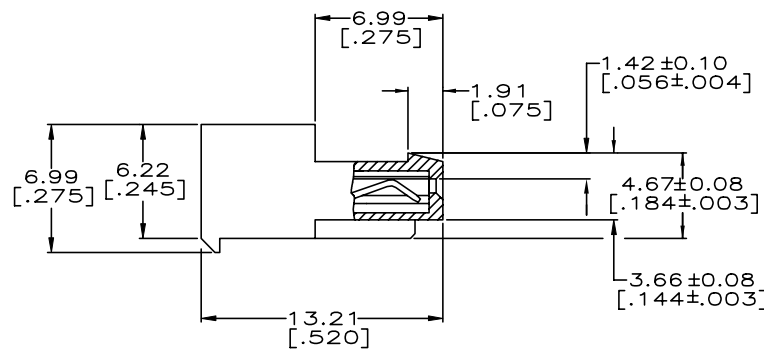


THIS DRAWING IS UNPUBLISHED. RELEASED FOR PUBLICATION  
 © COPYRIGHT - By - ALL RIGHTS RESERVED.

LOC	DIST	REVISIONS					
CM	00	P	LTR	DESCRIPTION	DATE	DWN	APVD
		Y		REVISED PER ECR-20-000727	22MAY2020	PC	SW

YES	71.12	[2.800]	28	5-640443-8
YES	68.58	[2.700]	27	5-640443-7
YES	66.04	[2.600]	26	5-640443-6
YES	63.50	[2.500]	25	5-640443-5
YES	60.96	[2.400]	24	5-640443-4
YES	58.42	[2.300]	23	5-640443-3
YES	55.88	[2.200]	22	5-640443-2
YES	53.34	[2.100]	21	5-640443-1
YES	50.80	[2.000]	20	5-640443-0
YES	48.26	[1.900]	19	4-640443-9
YES	45.72	[1.800]	18	4-640443-8
YES	43.18	[1.700]	17	4-640443-7
YES	40.64	[1.600]	16	4-640443-6
YES	38.10	[1.500]	15	4-640443-5
YES	35.56	[1.400]	14	4-640443-4
YES	33.02	[1.300]	13	4-640443-3
YES	30.48	[1.200]	12	4-640443-2
YES	27.94	[1.100]	11	4-640443-1
YES	25.40	[1.000]	10	4-640443-0
YES	22.86	[.900]	9	3-640443-9
YES	20.32	[.800]	8	3-640443-8
YES	17.78	[.700]	7	3-640443-7
YES	15.24	[.600]	6	3-640443-6
YES	12.70	[.500]	5	3-640443-5
YES	10.16	[.400]	4	3-640443-4
YES	7.62	[.300]	3	3-640443-3
YES	5.08	[.200]	2	3-640443-2

<del>NO</del>	<del>71.12</del>	<del>[2.800]</del>	<del>28</del>	<del>2-640443-8</del>	SUPERCEDED BY 5-640443-8
<del>NO</del>	<del>68.58</del>	<del>[2.700]</del>	<del>27</del>	<del>2-640443-7</del>	SUPERCEDED BY 5-640443-7
<del>NO</del>	<del>66.04</del>	<del>[2.600]</del>	<del>26</del>	<del>2-640443-6</del>	SUPERCEDED BY 5-640443-6
<del>NO</del>	<del>63.50</del>	<del>[2.500]</del>	<del>25</del>	<del>2-640443-5</del>	SUPERCEDED BY 5-640443-5
<del>NO</del>	<del>60.96</del>	<del>[2.400]</del>	<del>24</del>	<del>2-640443-4</del>	SUPERCEDED BY 5-640443-4
<del>NO</del>	<del>58.42</del>	<del>[2.300]</del>	<del>23</del>	<del>2-640443-3</del>	SUPERCEDED BY 5-640443-3
<del>NO</del>	<del>55.88</del>	<del>[2.200]</del>	<del>22</del>	<del>2-640443-2</del>	SUPERCEDED BY 5-640443-2
<del>NO</del>	<del>53.34</del>	<del>[2.100]</del>	<del>21</del>	<del>2-640443-1</del>	SUPERCEDED BY 5-640443-1
<del>NO</del>	<del>50.80</del>	<del>[2.000]</del>	<del>20</del>	<del>2-640443-0</del>	SUPERCEDED BY 5-640443-0
<del>NO</del>	<del>48.26</del>	<del>[1.900]</del>	<del>19</del>	<del>1-640443-9</del>	SUPERCEDED BY 4-640443-9
<del>NO</del>	<del>45.72</del>	<del>[1.800]</del>	<del>18</del>	<del>1-640443-8</del>	SUPERCEDED BY 4-640443-8
<del>NO</del>	<del>43.18</del>	<del>[1.700]</del>	<del>17</del>	<del>1-640443-7</del>	SUPERCEDED BY 4-640443-7
<del>NO</del>	<del>40.64</del>	<del>[1.600]</del>	<del>16</del>	<del>1-640443-6</del>	SUPERCEDED BY 4-640443-6
<del>NO</del>	<del>38.10</del>	<del>[1.500]</del>	<del>15</del>	<del>1-640443-5</del>	SUPERCEDED BY 4-640443-5
<del>NO</del>	<del>15.24</del>	<del>[.600]</del>	<del>6</del>	<del>640443-6</del>	SUPERCEDED BY 3-640443-6
<del>NO</del>	<del>12.70</del>	<del>[.500]</del>	<del>5</del>	<del>640443-5</del>	SUPERCEDED BY 3-640443-5
<del>NO</del>	<del>10.16</del>	<del>[.400]</del>	<del>4</del>	<del>640443-4</del>	SUPERCEDED BY 3-640443-4
<del>NO</del>	<del>7.62</del>	<del>[.300]</del>	<del>3</del>	<del>640443-3</del>	SUPERCEDED BY 3-640443-3
<del>NO</del>	<del>5.08</del>	<del>[.200]</del>	<del>2</del>	<del>640443-2</del>	SUPERCEDED BY 3-640443-2

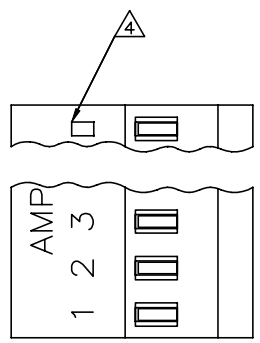

- 1 MATERIAL: CONNECTOR - NYLON UL94V-2 (GREEN). CONTACTS - 0.30[.012] THICK COPPER ALLOY BRIGHT TIN-LEAD .00203[.000080] MIN THICKNESS FOR 640443-2 THRU 2-640443-8. MATTE WHISKER MITIGATED TIN .00203[.000080] MIN THICKNESS OVER NICKEL UNDERPLATE FOR 3-640443-2 THRU 5-640443-8.
- 2 CONTACTS ACCEPT 28 AWG WIRE WITH 1.52[.060] MAX INSULATION DIAMETER.
- 3 CONTACTS MUST ACCEPT 0.64±0.03[.025±.001] POST AND REMAIN LOCKED IN POSITION.
- 4 IDENTIFICATION NUMBER FOR LAST CIRCUIT MAY NOT APPEAR ON ALL ASSEMBLIES.
- 5 DIMENSIONS IN BRACKETS ARE IN INCHES.
- 6 HOUSING FEATURES ARE: CLOSED END WITH LOCKING RAMP
- 7 OBSOLETE PARTS

THIS DRAWING IS A CONTROLLED DOCUMENT.		DWN S. CARPENTER 11JUN2003	TE Connectivity	
DIMENSIONS: mm [INCHES]		CHK D. BOSSI 11JUN2003	NAME	
TOLERANCES UNLESS OTHERWISE SPECIFIED:		APVD D. BOSSI 11JUN2003	PRODUCT SPEC	
0 PLC ±		108-1050		
1 PLC ±		APPLICATION SPEC		
2 PLC ± 0.13 [0.005]		114-1019		
3 PLC ±		SIZE CAGE CODE DRAWING NO		
4 PLC ±		A2 00779 C=640443		
5 PLC ±		RESTRICTED TO		
FINISH		WEIGHT		
1		CUSTOMER DRAWING		
		SCALE 5:1 SHEET 1 of 1 REV Y		

## X-ON Electronics

Largest Supplier of Electrical and Electronic Components

*Click to view similar products for [Headers & Wire Housings](#) category:*

*Click to view products by [TE Connectivity](#) manufacturer:*

Other Similar products are found below :

[95000-104TRLF](#) [10135584-644402LF](#) [DF62W-EP2022PCA](#) [95000-106TRLF](#) [DF62W-2022SCA](#) [DF62W-EP2022PC](#) [2203348](#) [DF62W-2022SC](#) [1084018](#) [1029039](#) [1084017](#) [802-10-012-10-002000](#) [1112640](#) [1112639](#) [000-34000](#) [0009482033](#) [0009507031](#) [57102-S06-03LF](#) [57202-S52-04LF](#) [PCN6-15S-2.5E](#) [0039019024](#) [58102-G61-06LF](#) [582553-1](#) [0009508121](#) [0050291907](#) [018731A](#) [LY20-4P-DT1-P1E-BR](#) [02.125.8002.8](#) [60101931](#) [60598-1 \(Cut Strip\)](#) [M1625-3R/100](#) [61062-3](#) [61082-181009](#) [636-1427](#) [638009-1](#) [641938-9](#) [641991-4](#) [644168-1](#) [647662-1](#) [65039-019ELF](#) [65817-002LF](#) [65817-015LF](#) [65863-015LF](#) [66207-023LF](#) [67016-026LF](#) [67046-001LF](#) [67095-007LF](#) [68002-116](#) [68016-236H](#) [68648-049](#)