THIS DRAWING IS UNPUBLISHED. RELEASED FOR PUBLICATION - ,- .
© COPYRIGHT - By - ALL RIGHTS RESERVED.

REVISIONS

P	LTR	DESCRIPTION	DATE	DWN	APVD
	H1	REVISED PER ECO-16-012733	01SEP2016	NK	MM

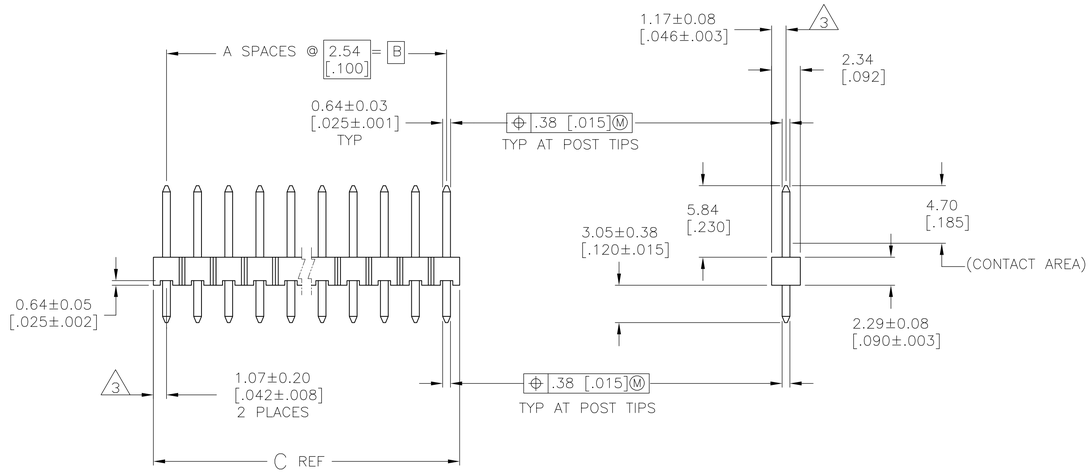

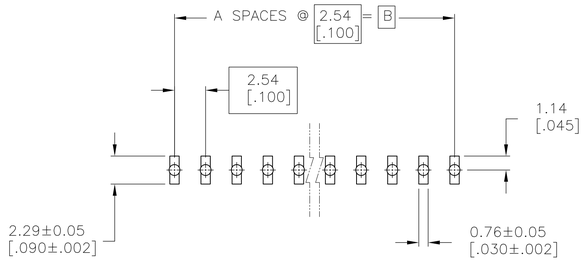

RECOMMENDED PC BOARD MOUNTING DIMENSIONS FOR .063 [1.60] THICK PC BOARD AND .012 [.305] STENCIL THICK.

1 ASSEMBLY MAY BE BROKEN TO THE DESIRED NUMBER OF POSITIONS.

2 TRUE POSITION TOLERANCE OF THE POST TIPS APPLIES WHEN THE HEADER IS HELD FLAT AGAINST THE PRINTED CIRCUIT BOARD.

3 THE NOTED DIMENSIONS APPLY AT THE INTERSECTION OF THE POST AND HOUSING.

4 PLATING: 0.00254-0.00508 [.000100-.000200] MATTE TIN LEAD, OVER 0.00127 [.000050] NICKEL.

5 HOUSING: LCP, COLOR-BLACK.
POSTS: COPPER ALLOY.

6 PLATING: 0.00254-0.00508 [.000100-.000200] MATTE TIN OVER 0.00127 [.000050] NICKEL.

7 OBSOLETE PARTS: OBSOLETE CIS STREAMLINING PER D.RENAUD/D.SINISI.

PLATING	C	B	A	NO. OF POSITIONS	PART NUMBER
6	101.19 [3.984]	99.06 [3.900]	39	40	9-146278-0
6	98.65 [3.884]	96.52 [3.800]	38	39	7 ~~8-146278-9~~
6	96.11 [3.784]	93.98 [3.700]	37	38	7 ~~8-146278-8~~
6	93.57 [3.684]	91.44 [3.600]	36	37	7 ~~8-146278-7~~
6	91.03 [3.584]	88.90 [3.500]	35	36	7 ~~8-146278-6~~
6	88.49 [3.484]	86.36 [3.400]	34	35	7 ~~8-146278-5~~
6	85.95 [3.384]	83.82 [3.300]	33	34	7 ~~8-146278-4~~
6	83.41 [3.284]	81.28 [3.200]	32	33	7 ~~8-146278-3~~
6	80.87 [3.184]	78.74 [3.100]	31	32	7 ~~8-146278-2~~
6	78.33 [3.084]	76.20 [3.000]	30	31	7 ~~8-146278-1~~
6	75.79 [2.984]	73.66 [2.900]	29	30	7 ~~8-146278-0~~
6	73.25 [2.884]	71.12 [2.800]	28	29	7 ~~7-146278-9~~
6	70.71 [2.784]	68.58 [2.700]	27	28	7-146278-8
6	68.17 [2.684]	66.04 [2.600]	26	27	7 ~~7-146278-7~~
6	65.63 [2.584]	63.5 [2.500]	25	26	7 ~~7-146278-6~~
6	63.09 [2.484]	60.96 [2.400]	24	25	7 ~~7-146278-5~~
6	60.55 [2.384]	58.42 [2.300]	23	24	7 ~~7-146278-4~~
6	58.01 [2.284]	55.88 [2.200]	22	23	7 ~~7-146278-3~~
6	55.47 [2.184]	53.34 [2.100]	21	22	7 ~~7-146278-2~~
6	52.93 [2.084]	50.80 [2.000]	20	21	7 ~~7-146278-1~~
6	50.39 [1.984]	48.26 [1.900]	19	20	7 ~~7-146278-0~~
6	47.85 [1.884]	45.72 [1.800]	18	19	7 ~~6-146278-9~~
6	45.31 [1.784]	43.18 [1.700]	17	18	7 ~~6-146278-8~~
6	42.77 [1.684]	40.64 [1.600]	16	17	7 ~~6-146278-7~~
6	40.23 [1.584]	38.10 [1.500]	15	16	7 ~~6-146278-6~~
6	37.69 [1.484]	35.56 [1.400]	14	15	7 ~~6-146278-5~~
6	35.15 [1.384]	33.02 [1.300]	13	14	6-146278-4
6	32.61 [1.284]	30.48 [1.200]	12	13	7 ~~6-146278-3~~
6	30.07 [1.184]	27.94 [1.100]	11	12	6-146278-2
6	27.53 [1.084]	25.40 [1.000]	10	11	7 ~~6-146278-1~~
6	24.99 [.984]	22.86 [.900]	9	10	6-146278-0
6	22.45 [.884]	20.32 [.800]	8	9	5-146278-9
6	19.91 [.784]	17.78 [.700]	7	8	5-146278-8
6	17.37 [.684]	15.24 [.600]	6	7	5-146278-7
6	14.83 [.584]	12.70 [.500]	5	6	5-146278-6
6	12.29 [.484]	10.16 [.400]	4	5	5-146278-5
6	9.75 [.384]	7.62 [.300]	3	4	5-146278-4
6	7.21 [.284]	5.08 [.200]	2	3	5-146278-3
6	4.67 [.184]	2.54 [.100]	1	2	5-146278-2
6	2.13 [.084]	– [–]	0	1	5-146278-1

PLATING	C	B	A	NO. OF POSITIONS	PART NUMBER
4	101.19 [3.984]	99.06 [3.900]	39	40	4-146278-0
4	98.65 [3.884]	96.52 [3.800]	38	39	7 ~~3-146278-9~~
4	96.11 [3.784]	93.98 [3.700]	37	38	7 ~~3-146278-8~~
4	93.57 [3.684]	91.44 [3.600]	36	37	7 ~~3-146278-7~~
4	91.03 [3.584]	88.90 [3.500]	35	36	7 ~~3-146278-6~~
4	88.49 [3.484]	86.36 [3.400]	34	35	7 ~~3-146278-5~~
4	85.95 [3.384]	83.82 [3.300]	33	34	7 ~~3-146278-4~~
4	83.41 [3.284]	81.28 [3.200]	32	33	7 ~~3-146278-3~~
4	80.87 [3.184]	78.74 [3.100]	31	32	7 ~~3-146278-2~~
4	78.33 [3.084]	76.20 [3.000]	30	31	7 ~~3-146278-1~~
4	75.79 [2.984]	73.66 [2.900]	29	30	7 ~~3-146278-0~~
4	73.25 [2.884]	71.12 [2.800]	28	29	7 ~~2-146278-9~~
4	70.71 [2.784]	68.58 [2.700]	27	28	7 ~~2-146278-8~~
4	68.17 [2.684]	66.04 [2.600]	26	27	7 ~~2-146278-7~~
4	65.63 [2.584]	63.5 [2.500]	25	26	7 ~~2-146278-6~~
4	63.09 [2.484]	60.96 [2.400]	24	25	7 ~~2-146278-5~~
4	60.55 [2.384]	58.42 [2.300]	23	24	7 ~~2-146278-4~~
4	58.01 [2.284]	55.88 [2.200]	22	23	7 ~~2-146278-3~~
4	55.47 [2.184]	53.34 [2.100]	21	22	7 ~~2-146278-2~~
4	52.93 [2.084]	50.80 [2.000]	20	21	7 ~~2-146278-1~~
4	50.39 [1.984]	48.26 [1.900]	19	20	7 ~~2-146278-0~~
4	47.85 [1.884]	45.72 [1.800]	18	19	7 ~~1-146278-9~~
4	45.31 [1.784]	43.18 [1.700]	17	18	7 ~~1-146278-8~~
4	42.77 [1.684]	40.64 [1.600]	16	17	7 ~~1-146278-7~~
4	40.23 [1.584]	38.10 [1.500]	15	16	7 ~~1-146278-6~~
4	37.69 [1.484]	35.56 [1.400]	14	15	7 ~~1-146278-5~~
4	35.15 [1.384]	33.02 [1.300]	13	14	7 ~~1-146278-4~~
4	32.61 [1.284]	30.48 [1.200]	12	13	7 ~~1-146278-3~~
4	30.07 [1.184]	27.94 [1.100]	11	12	7 ~~1-146278-2~~
4	27.53 [1.084]	25.40 [1.000]	10	11	7 ~~1-146278-1~~
4	24.99 [.984]	22.86 [.900]	9	10	7 ~~1-146278-0~~
4	22.45 [.884]	20.32 [.800]	8	9	7 ~~146278-9~~
4	19.91 [.784]	17.78 [.700]	7	8	7 ~~146278-8~~
4	17.37 [.684]	15.24 [.600]	6	7	7 ~~146278-7~~
4	14.83 [.584]	12.70 [.500]	5	6	7 ~~146278-6~~
4	12.29 [.484]	10.16 [.400]	4	5	7 ~~146278-5~~
4	9.75 [.384]	7.62 [.300]	3	4	7 ~~146278-4~~
4	7.21 [.284]	5.08 [.200]	2	3	7 ~~146278-3~~
4	4.67 [.184]	2.54 [.100]	1	2	146278-2
4	2.13 [.084]	– [–]	0	1	7 ~~146278-1~~

THIS DRAWING IS A CONTROLLED DOCUMENT.

DIMENSIONS: mm [INCHES]

TOLERANCES UNLESS OTHERWISE SPECIFIED:
0 PLC ± –
1 PLC ± –
2 PLC ± 0.51[.02]
3 PLC ± 0.127[.005]
4 PLC ± 0.0127[.0005]
ANGLES ± –

MATERIAL 5

FINISH SEE TABLE

DWN T. HOFFMAN 23 MAY 95
CHK G. DUBNICZKI 07 JUN 95
APVD G. DUBNICZKI 07 JUN 95

PRODUCT SPEC –
APPLICATION SPEC –
WEIGHT –

CUSTOMER DRAWING

TE Connectivity

NAME HEADER ASSEMBLY, MOD II, BREAKAWAY, SINGLE ROW, HIGH TEMPERATURE, VERTICAL, W/.025 SQ. POSTS

SIZE	CAGE CODE	DRAWING NO	RESTRICTED TO
A1	00779	C-146278	–

SCALE 4:1 SHEET 1 OF 1 REV H1

X-ON Electronics

Largest Supplier of Electrical and Electronic Components

Click to view similar products for Headers & Wire Housings ***category:***

Click to view products by TE Connectivity ***manufacturer:***

Other Similar products are found below :

892-18-020-10-001101 58102-G61-06LF 582553-1 0009485154 009176003701906 0050291907 LY20-4P-DT1-P1E-BR 02.125.8002.8 609-3404 61062-3 61082-181009 622-3653LF 63453-116 636-1030 636-1427 636-3427 636-4007 641938-9 641991-4 644827-2 65817-010LF 65817-015LF 65863-015LF 66207-023LF 67095-007LF 67601157 68645-018 68648-049 70.362.1628.0 70-4210 70-4226B 70-4853B 707-5020 707-5028 71.350.2428.0 71918-208LF 71961-016LF 733-134 733-162 754199-000 760-3052 787-8014-00 79531-3000 FCN-360C032-B FCN-367T-T012/H FCN-723D010/2 80.063.4001.1 800-90-001-10-001000 800-90-010-10-002000 801-43-002-10-013000